


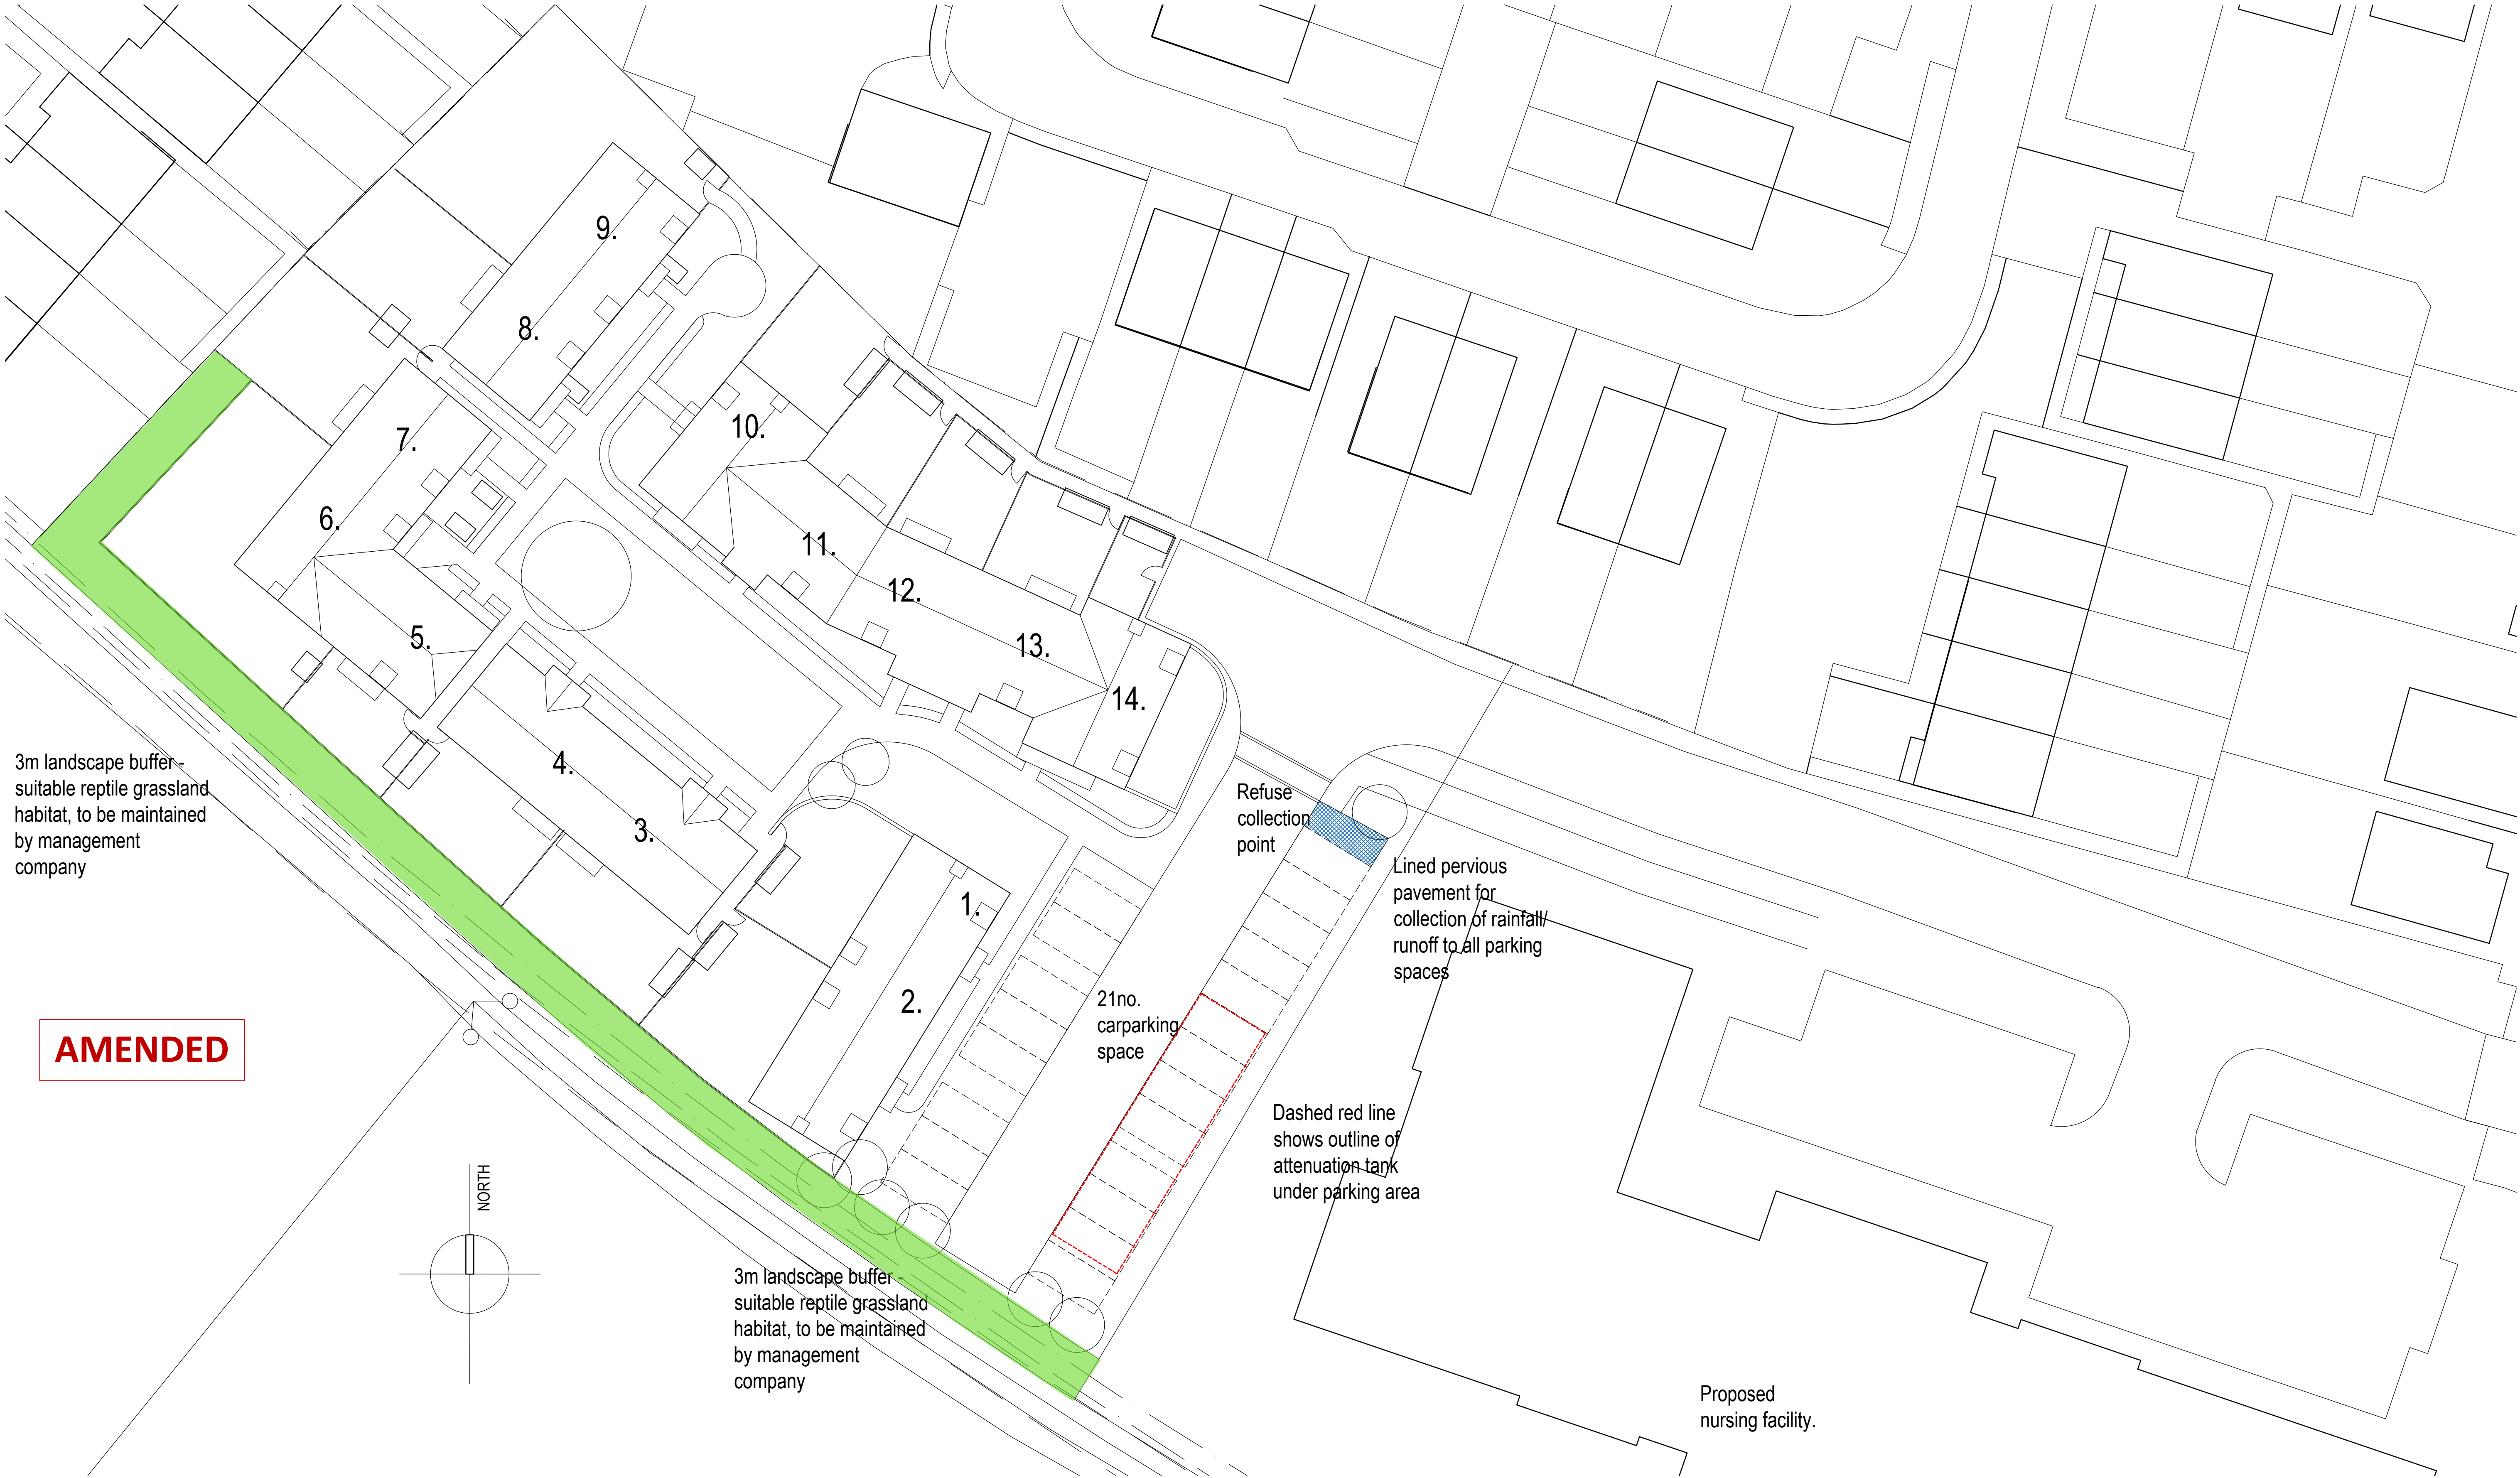

Rev.	Description	Int.	Date
A	Updates following comments from planning officer	HW	Jan 2020
B	Landscape/ reptile buffer amended	HW	March20

Client	HUME PLANNING
Job Title	PROPOSED RETIREMENT COTTAGES AT IWADE

CDP

CDP Architecture Ltd

22-23 North Lane, Canterbury


Kent, CT2 7EE

Tel: 01227 458181

Fax: 01227 451543

info@thinkcdp.com

www.thinkcdp.com

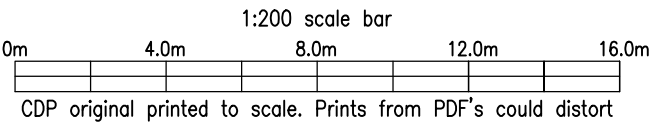

Drawing Title	PROPOSED SITE PLAN
---------------	--------------------

Scale @ A1	1:200	Preliminary/Comment
Drawn	MW	Planning
Date	AUG 2019	Building Regulations
Checked		Tender
		Construction
		As built

766	:	P02	B
-----	---	-----	---